LEGEND

- Stormwater pipes to be PVC-U Class SN4 @ Min. 1% (to AS/NZS 1254:2010).
- Sewer pipes to be DWV PVC-U Class SN6 @ Min. 1.65% (to AS/NZS 1260:2009).

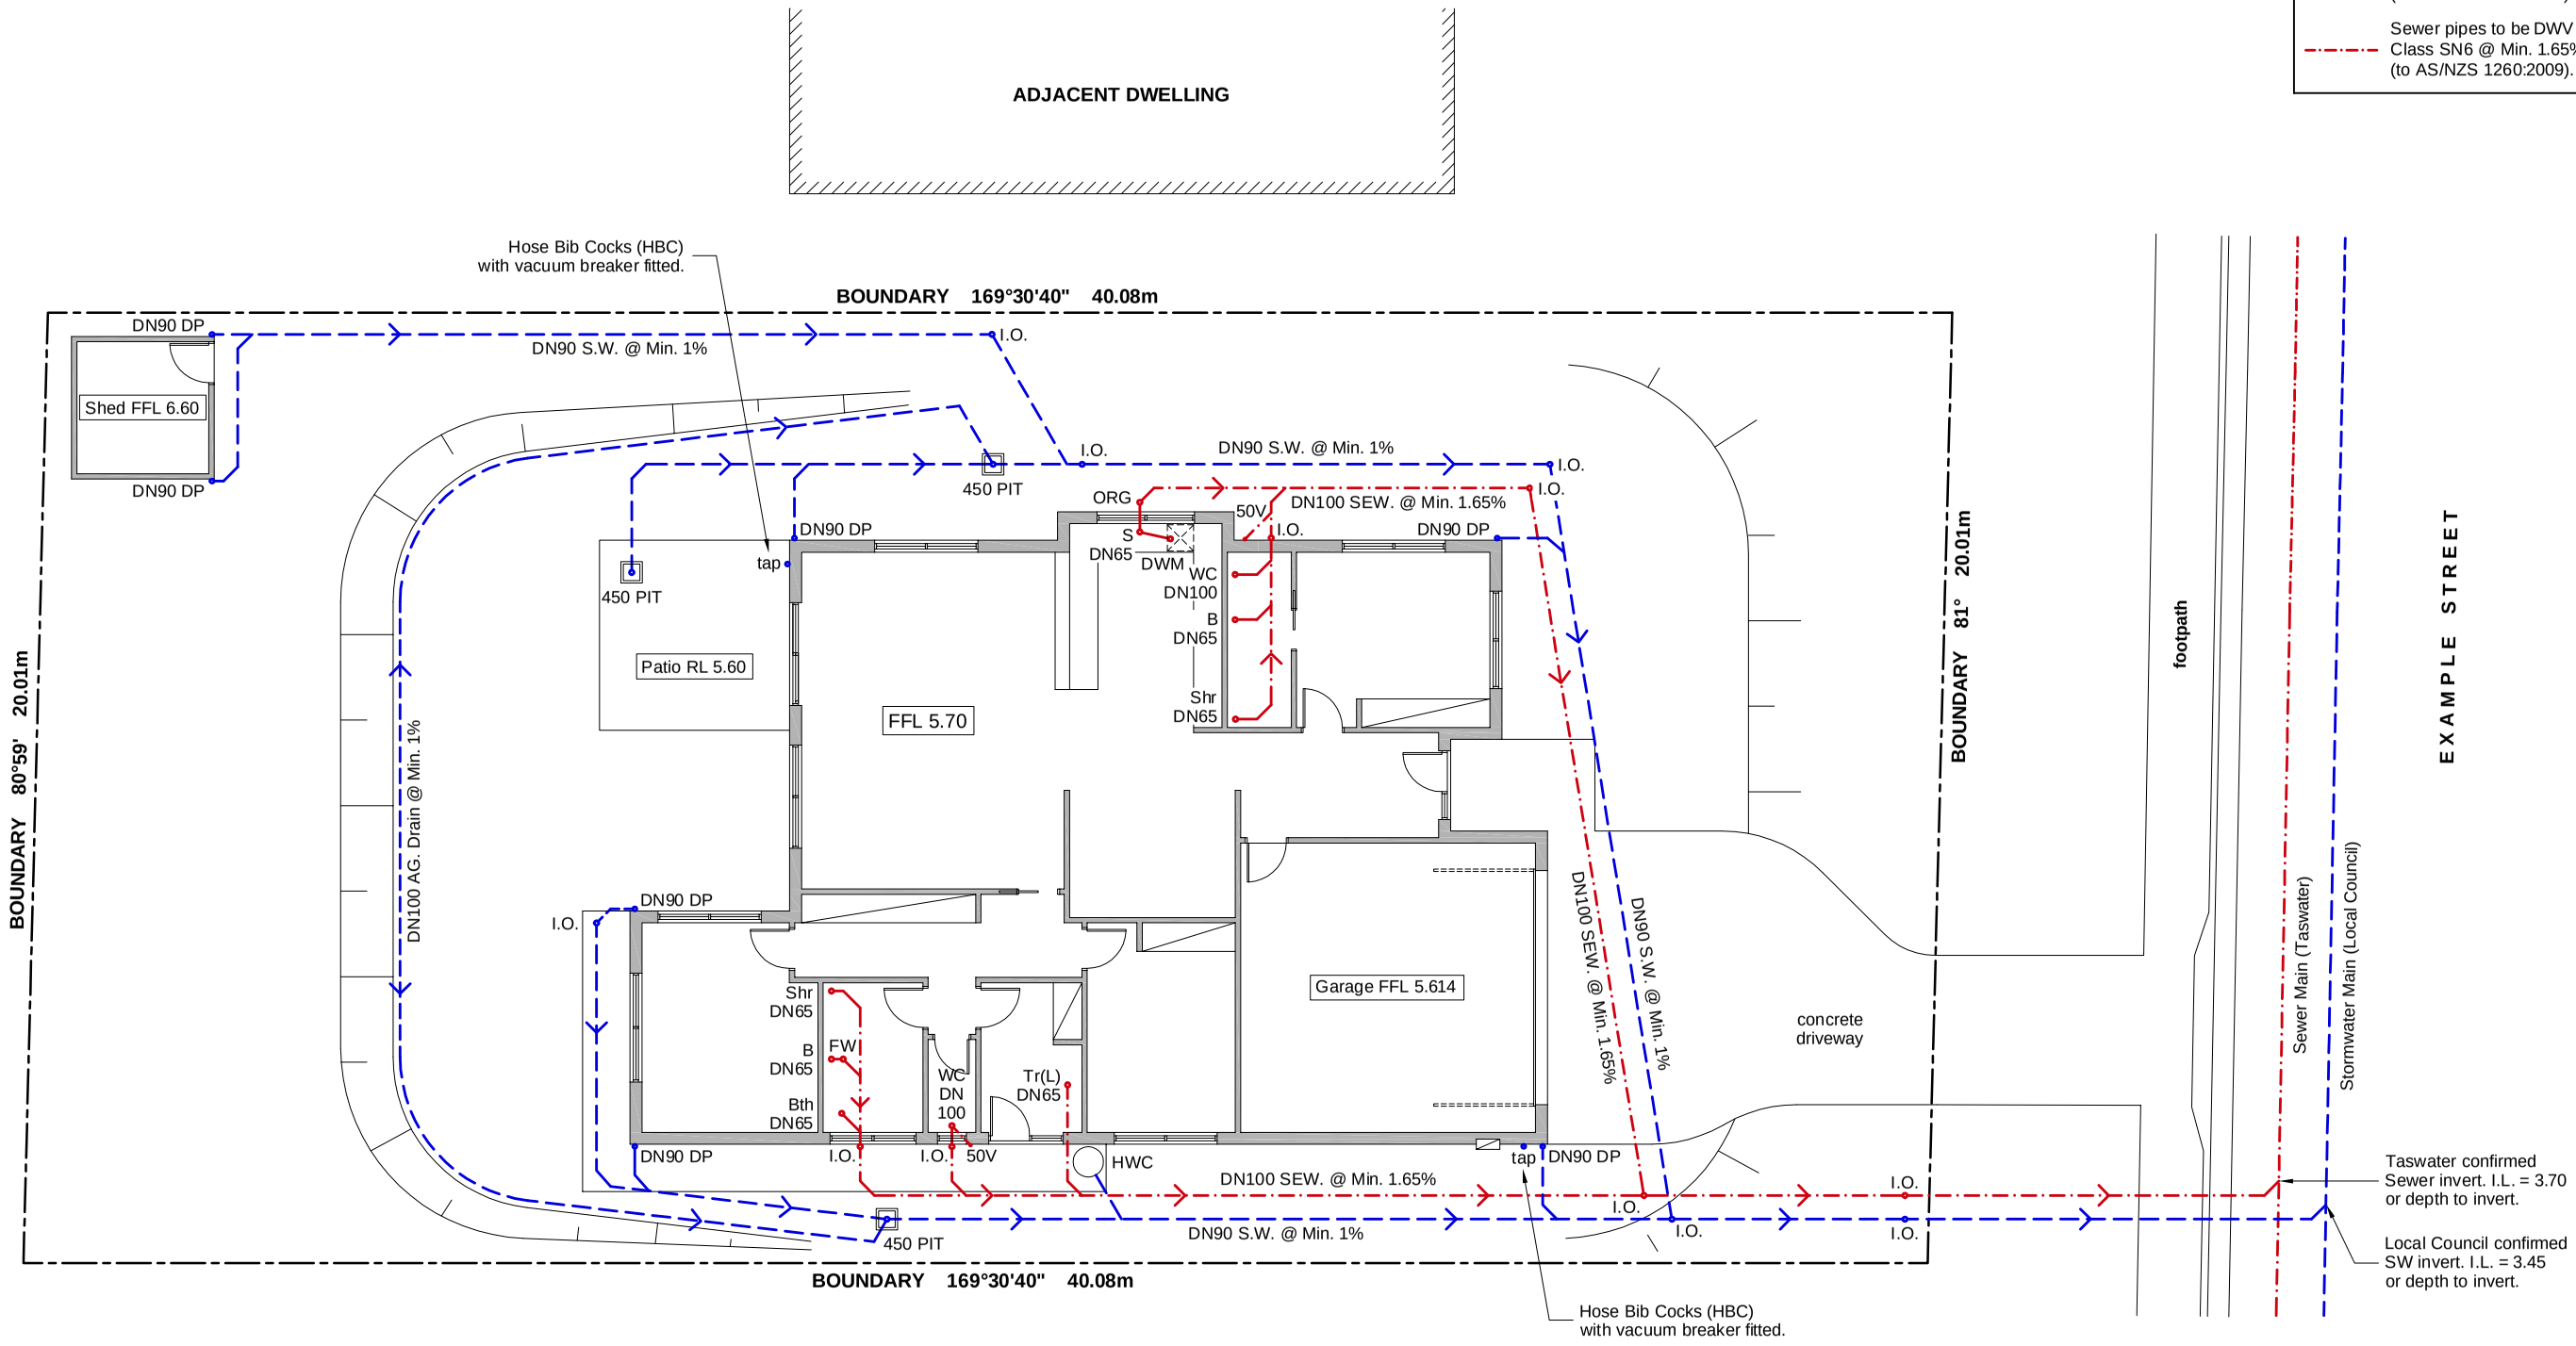

Rev.	Amendment	Date

Accredited Practitioner:
Name
Address
Phone number

North

Tasmanian Government

Owner / Client:
Building Standards & Occupational Licensing
Project:
Class 1a (Schedule 3, As Constructed)
1 Example Street, TASMANIA

Drawing Title:
Site Plan

Date:
09/11/2016

Scale:
1:150 @ A3

Status:
INFORMATION

Drawing No.: **H01** (1 of 1)

Rev **-**